
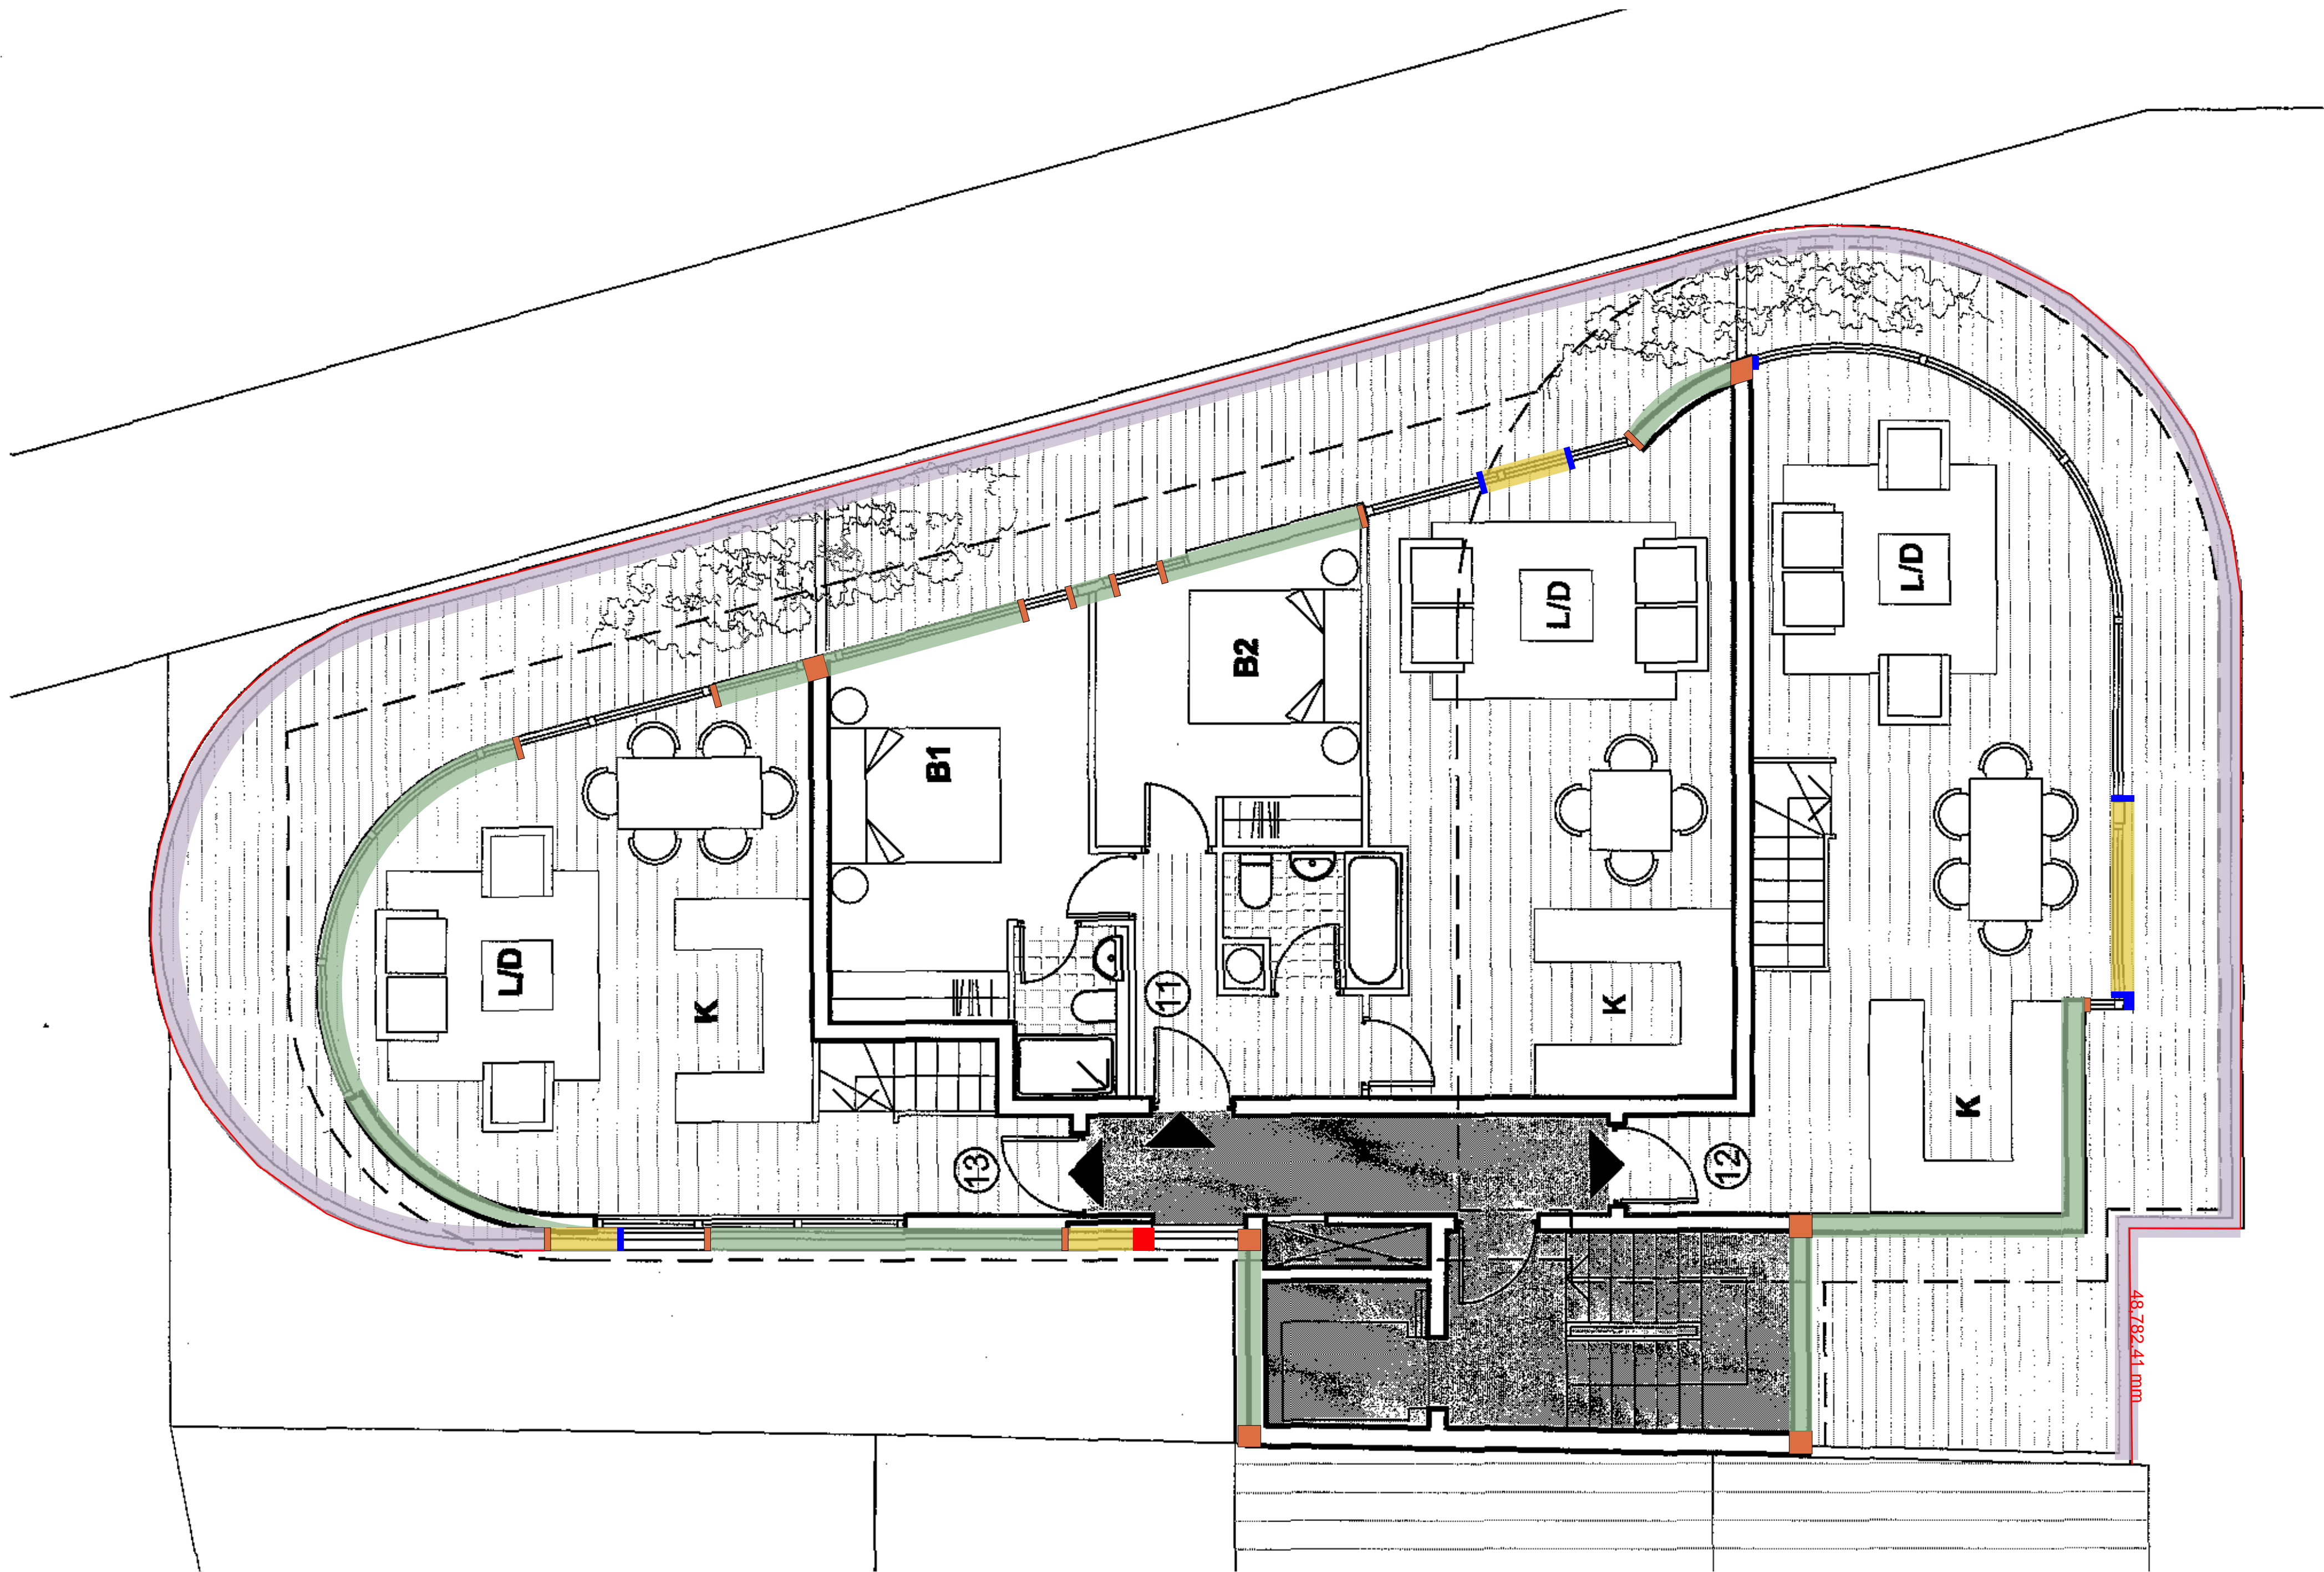


PLEASE NOTE:
THESE ARE **NOT** AS BUILT DRAWINGS. ALL
DISCREPANCIES ARE DUE TO "AS BUILT" INFORMATION
AVAILABLE - NEEDS FURTHER CONFIRMATION

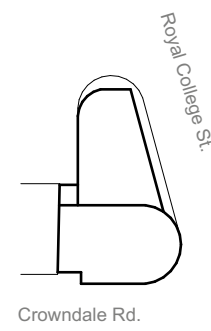

- KEY
- Cavity Barrier 30min Integrity/15min Insulation (tbc Marshalls)
 - Cavity Barrier 30min Integrity/15min Insulation OSCB (open state cavity barrier)
 - Cavity Barrier around Windows and Doors 30min Integrity/15min Insulation
 - Cavity Barrier around Windows and Openings 30min Integrity/15min Insulation OSCB (open state cavity barrier)
 - Cavity Barrier (Rockwool Firepro SP Firestop) **NBS P10/432**
 - WT 01 - Aluminium Rainscreen Cladding Wall
 - WT 02 - Cavity Brickwork Wall
 - WT 03 - EPS Rendered Wall on Brickwork
 - WT 04 - Soffit/Overhang on Groundfloor & Balconies
 - WT 05 - Metal Panels - Projecting Balconies (backing substrate unknown)
 - WT 06 - Parapet to Terraces and Inset Balconies

REV 03- Updated External Wall Details

CREATE
DESIGN + ARCHITECTURE

Wigglesworth House 69 Southwark Bridge Road London SE1 9HH
+44 207 021 0267 info@createdesign.org www.createdesign.org

CROWNDALE HOUSE
NW1 1TT
Client
Fairway Property Investments Ltd.

RE-CLADDING OF RESIDENTIAL BUILDING
PLAN MARKUPS
FIFTH FLOOR PLAN

CDA Ref 704 Scale(s) 1:50, 1:1 Original Paper Size A1

Drawing Number
Project Originator Volume Level Type Role Class Number
704 CDA XX 00 DR A 21 0105

Revision 03 - WIP Revision Description FOR TENDER

This document and its design content is copyright ©. It shall be read in conjunction with all other associated project information including models, specifications, schedules and related consultants documents. Do not scale from documents. All dimensions to be checked on site. Immediately report any discrepancies, errors or omissions on this document to the Originator. If in doubt ASK.